

(2) Removal of the large commercial vessel waiting facility to the south of the proposed crossing

What is being consulted upon?

The original Stage 3 consultation documents explained that consideration is being given to a potential large commercial vessel waiting facility, for use in the event that the proposed bridge fails to operate. The documents also explained that the need for this facility would be confirmed in the application for the Development Consent Order (DCO).


It is now proposed that this waiting facility will not be included in the scheme that will form the application for a DCO. The reason for this proposal is explained on the following drawing.

How to respond to the consultation

Any response to this consultation should be made by:

- **Emailing:** gy3rc-st3consultation@norfolk.gov.uk
- **Writing to:** Freepost Plus RTCL-XSTT-JZSK, Norfolk County Council, GY3RC, Ground floor - south wing, County Hall, Martineau Lane, Norwich NR1 2DH

The deadline for receipt of responses to this consultation is 23:59hrs on 17 March 2019.

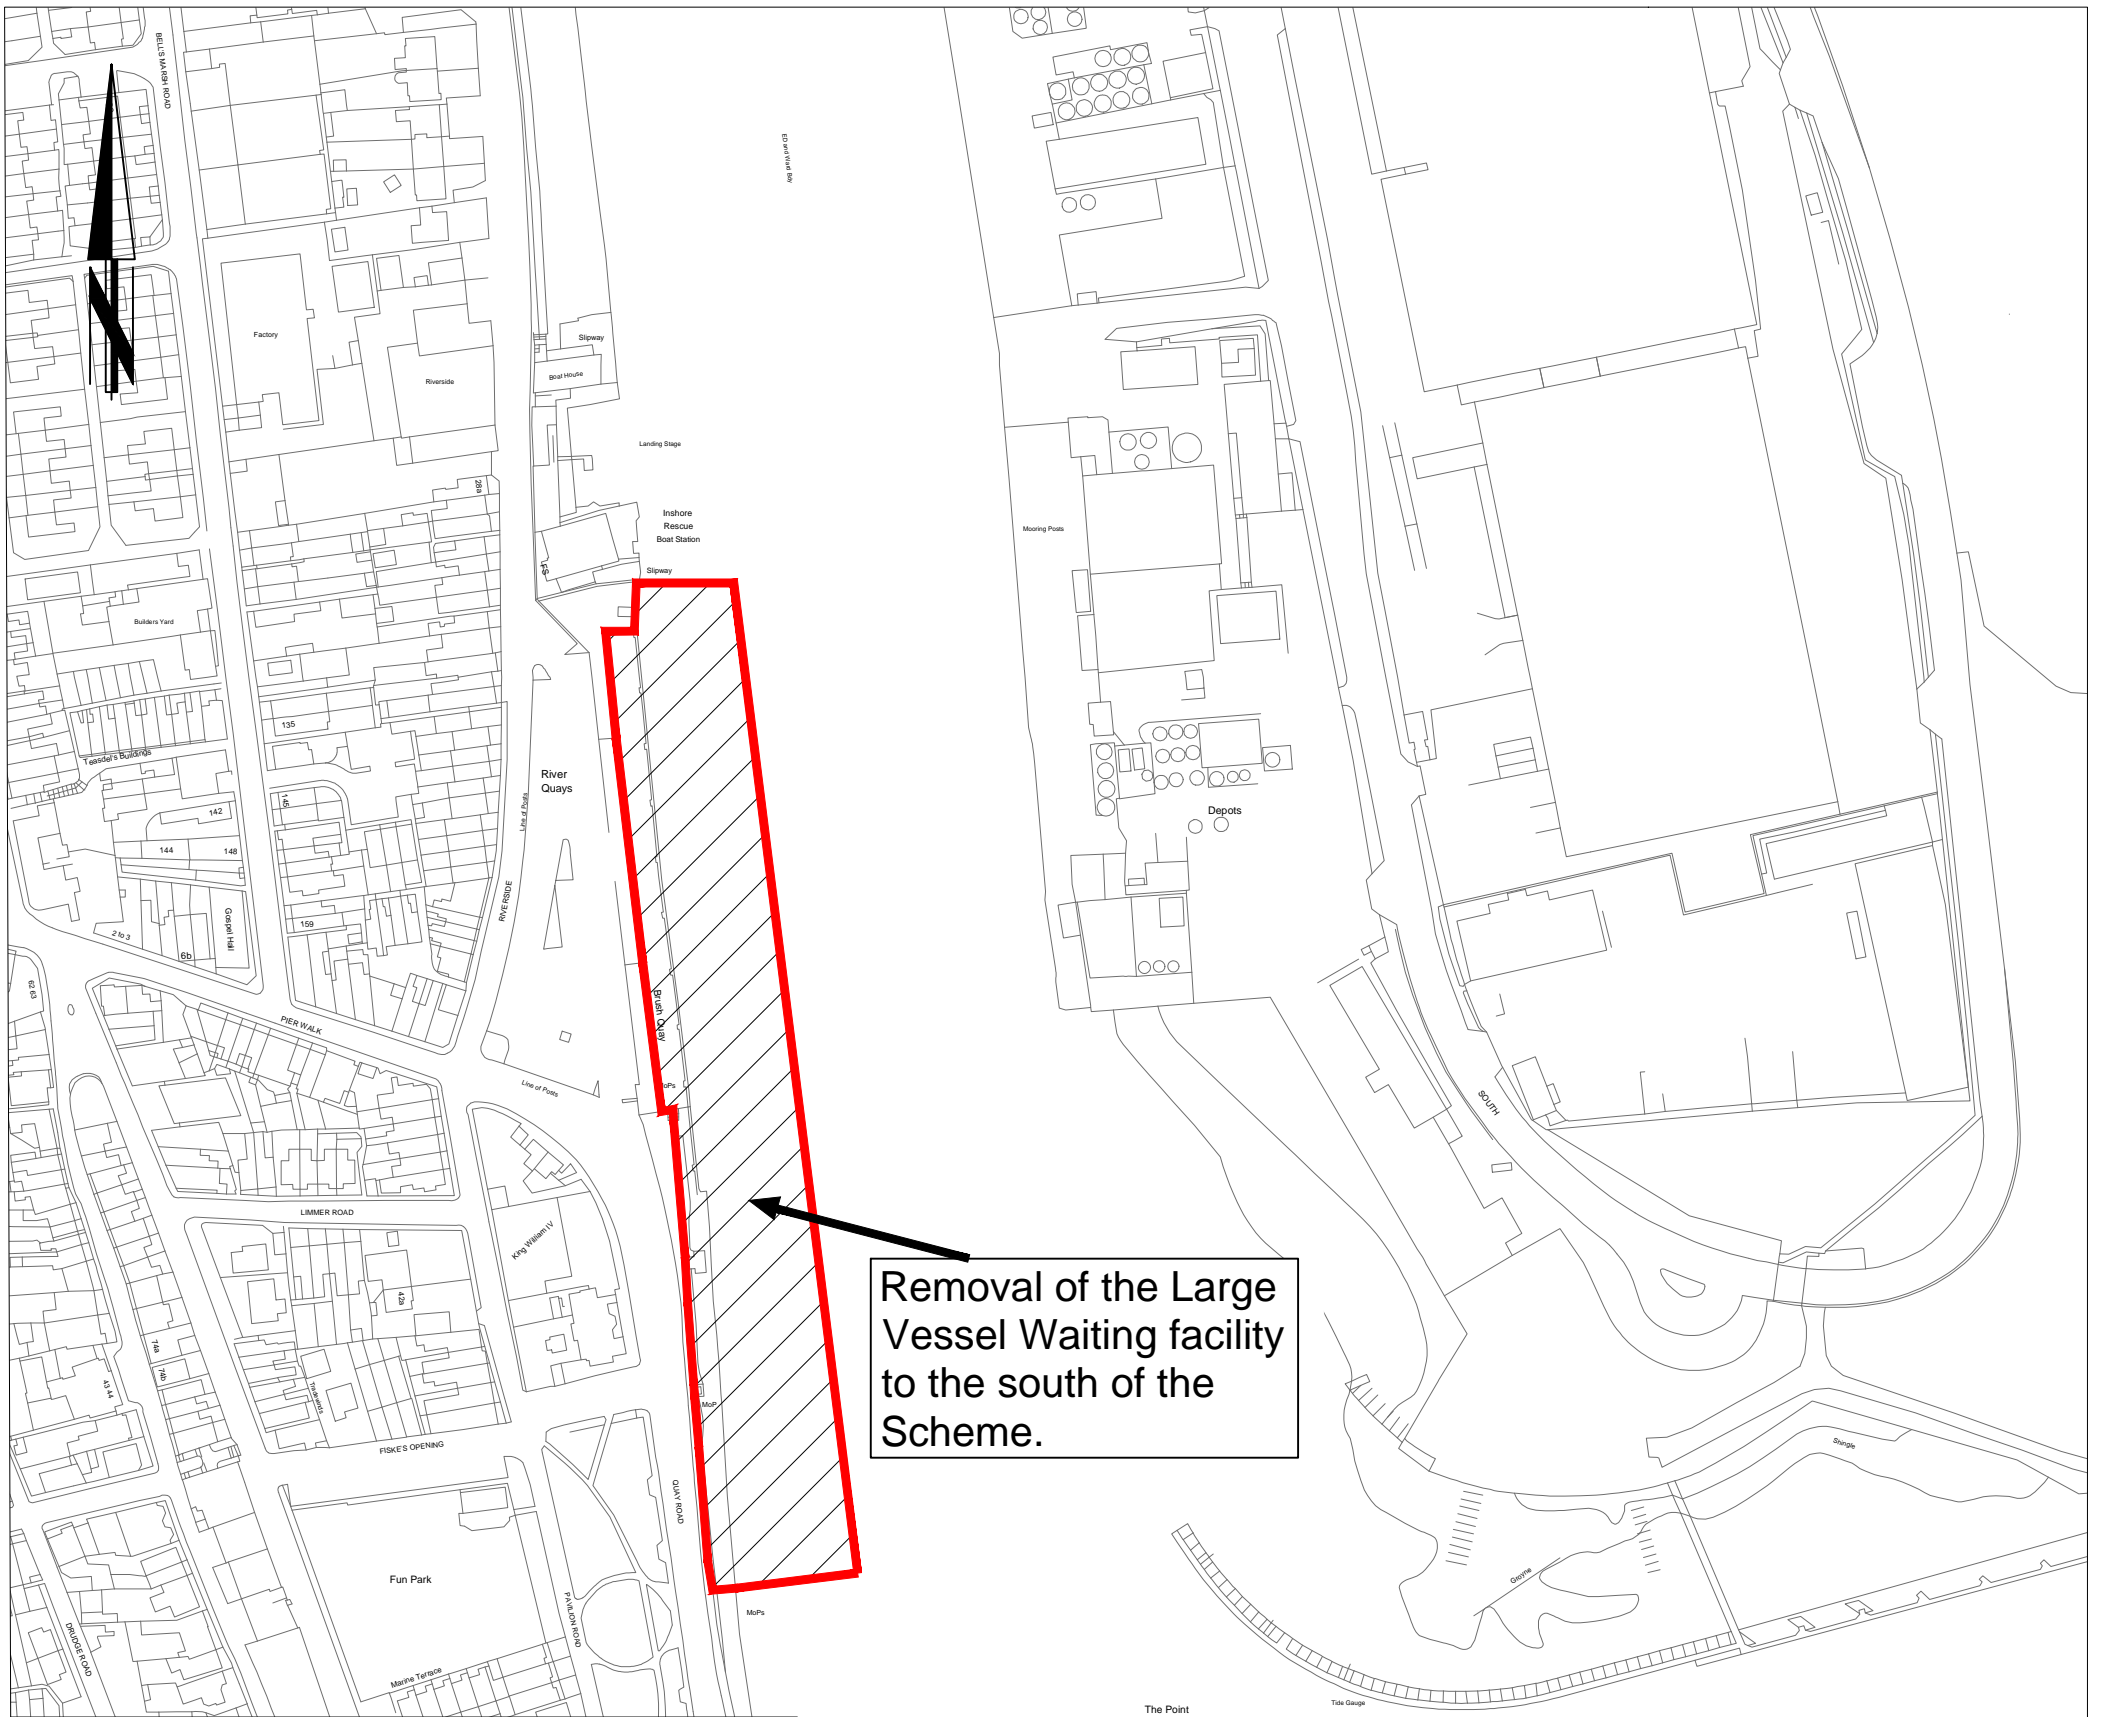

Removal of the Large Vessel Waiting facility to the south of the Scheme.

Key


- Red Line Boundary consulted upon in Summer 2018
- Proposed reduction of Red Line Boundary
- Area of Red Line Boundary reduction

Description of Change

Removal of the Large Vessel Waiting facility to the south of the Scheme.

Reason for Change

A robust assessment of the risk levels of a bridge failure during a large vessel movement has been undertaken. This shows that the risk rating for these larger vessels will be low and would be considered acceptable under the processes laid out in the Port Marine Safety Code and the Port Operator's Marine Safety Management Systems. It is therefore concluded that the risks to large commercial vessels associated with a bridge failure do not warrant the provision of this large vessel waiting facility.

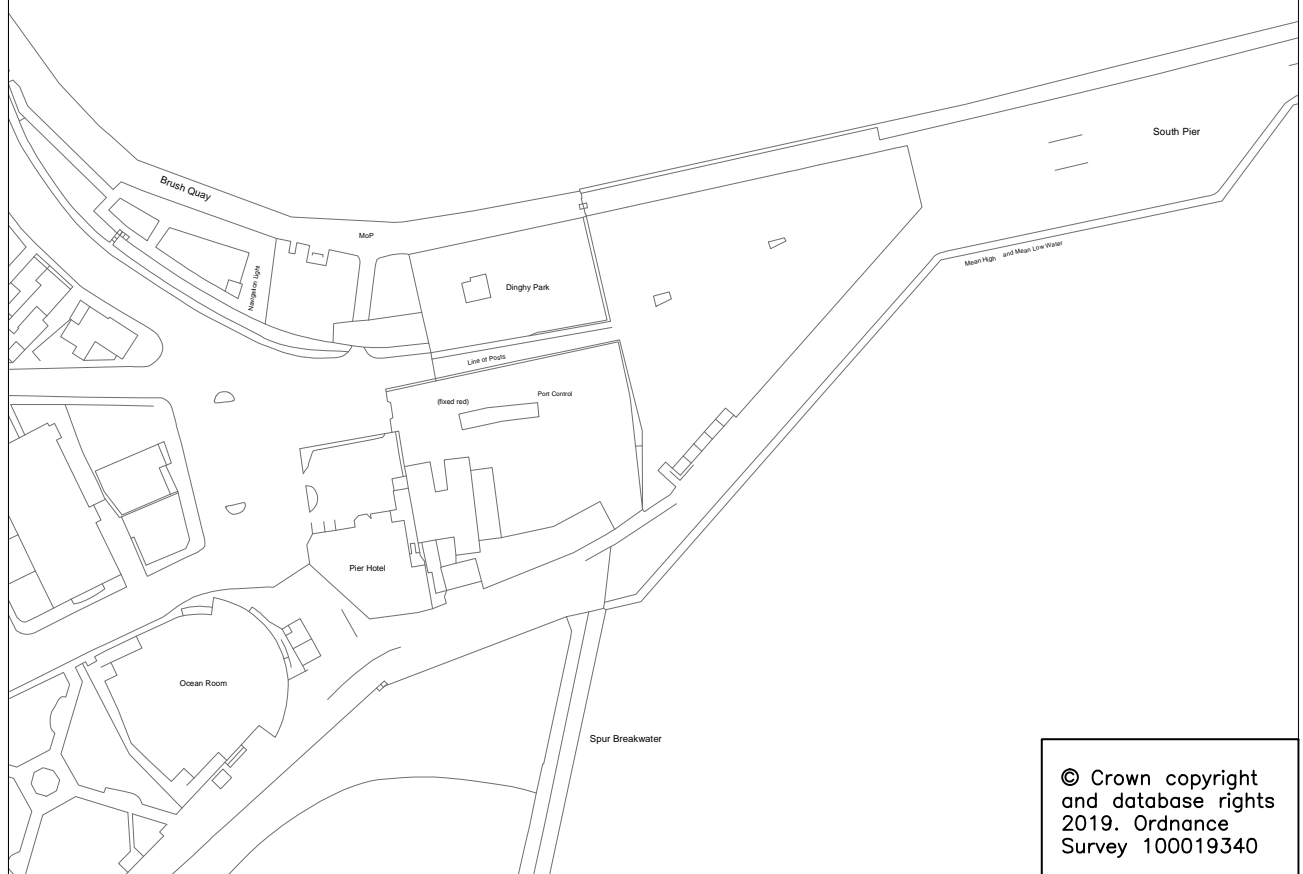

© Crown copyright and database rights 2019. Ordnance Survey 100019340



DRAWING TITLE
Great Yarmouth Third River Crossing
Further Consultation Design Changes
Area 6: Removal of Large Vessel Waiting Facility

Tom McCabe
Executive Director of
Community and Environmental Services
Norfolk County Council
County Hall
Martineau Lane
Norwich NR1 2SG

REV.	DESCRIPTION	DRAWN	CHECKED	DATE

	INITIAL	DATE	DRAWING No.
SURVEYED BY	OS	02/19	PKA018-MP-103
DESIGNED BY	KP	02/19	PROJECT TITLE
DRAWN BY	KP	02/19	Great Yarmouth Third River Crossing
CHECKED BY	GB	02/19	SCALE FILE No.
			NTS PKA018